

ELECTRIC

- E1 0.5 Amp (SpANAE) electrical supply to Switched Spur mounted on wall at 1200mm above...

- E16 16 Amp (SpANAE) electrical supply to Switched Spur mounted on wall at 1200mm above...

ELECTRICAL NOTES

- 1 All equipment to be earth bonded by site electrical contractor.

GAS

- G1 22mm Bsp Natural Gas connection to Item 50 (WOOD BURNING OVEN) - 115,000 Btu/Hr...

GAS NOTES

- 1 Mechanical Contractor to install main gas flint manifold to rear of cookline with 'T' joints...

WATER

- W1 3 OFF 15mm HOT & TANK COLD WATER supplies terminated vertically against wall with stopcocks...

WATER NOTES

- 1 Mechanical Contractor to run water supplies to correctly sized connection points as identified...

DRAINAGE


- D1 3 OFF 35mm vertical waste outlets from Items 6A(2) & 23A - 3 OFF HAND WASH BASINS...

DRAINAGE NOTES

- 1 Mechanical Contractor to run waste floats with 'T' joints and correctly sized waste outlets...

GENERAL NOTES

- 1 All dimensions to be verified on site.

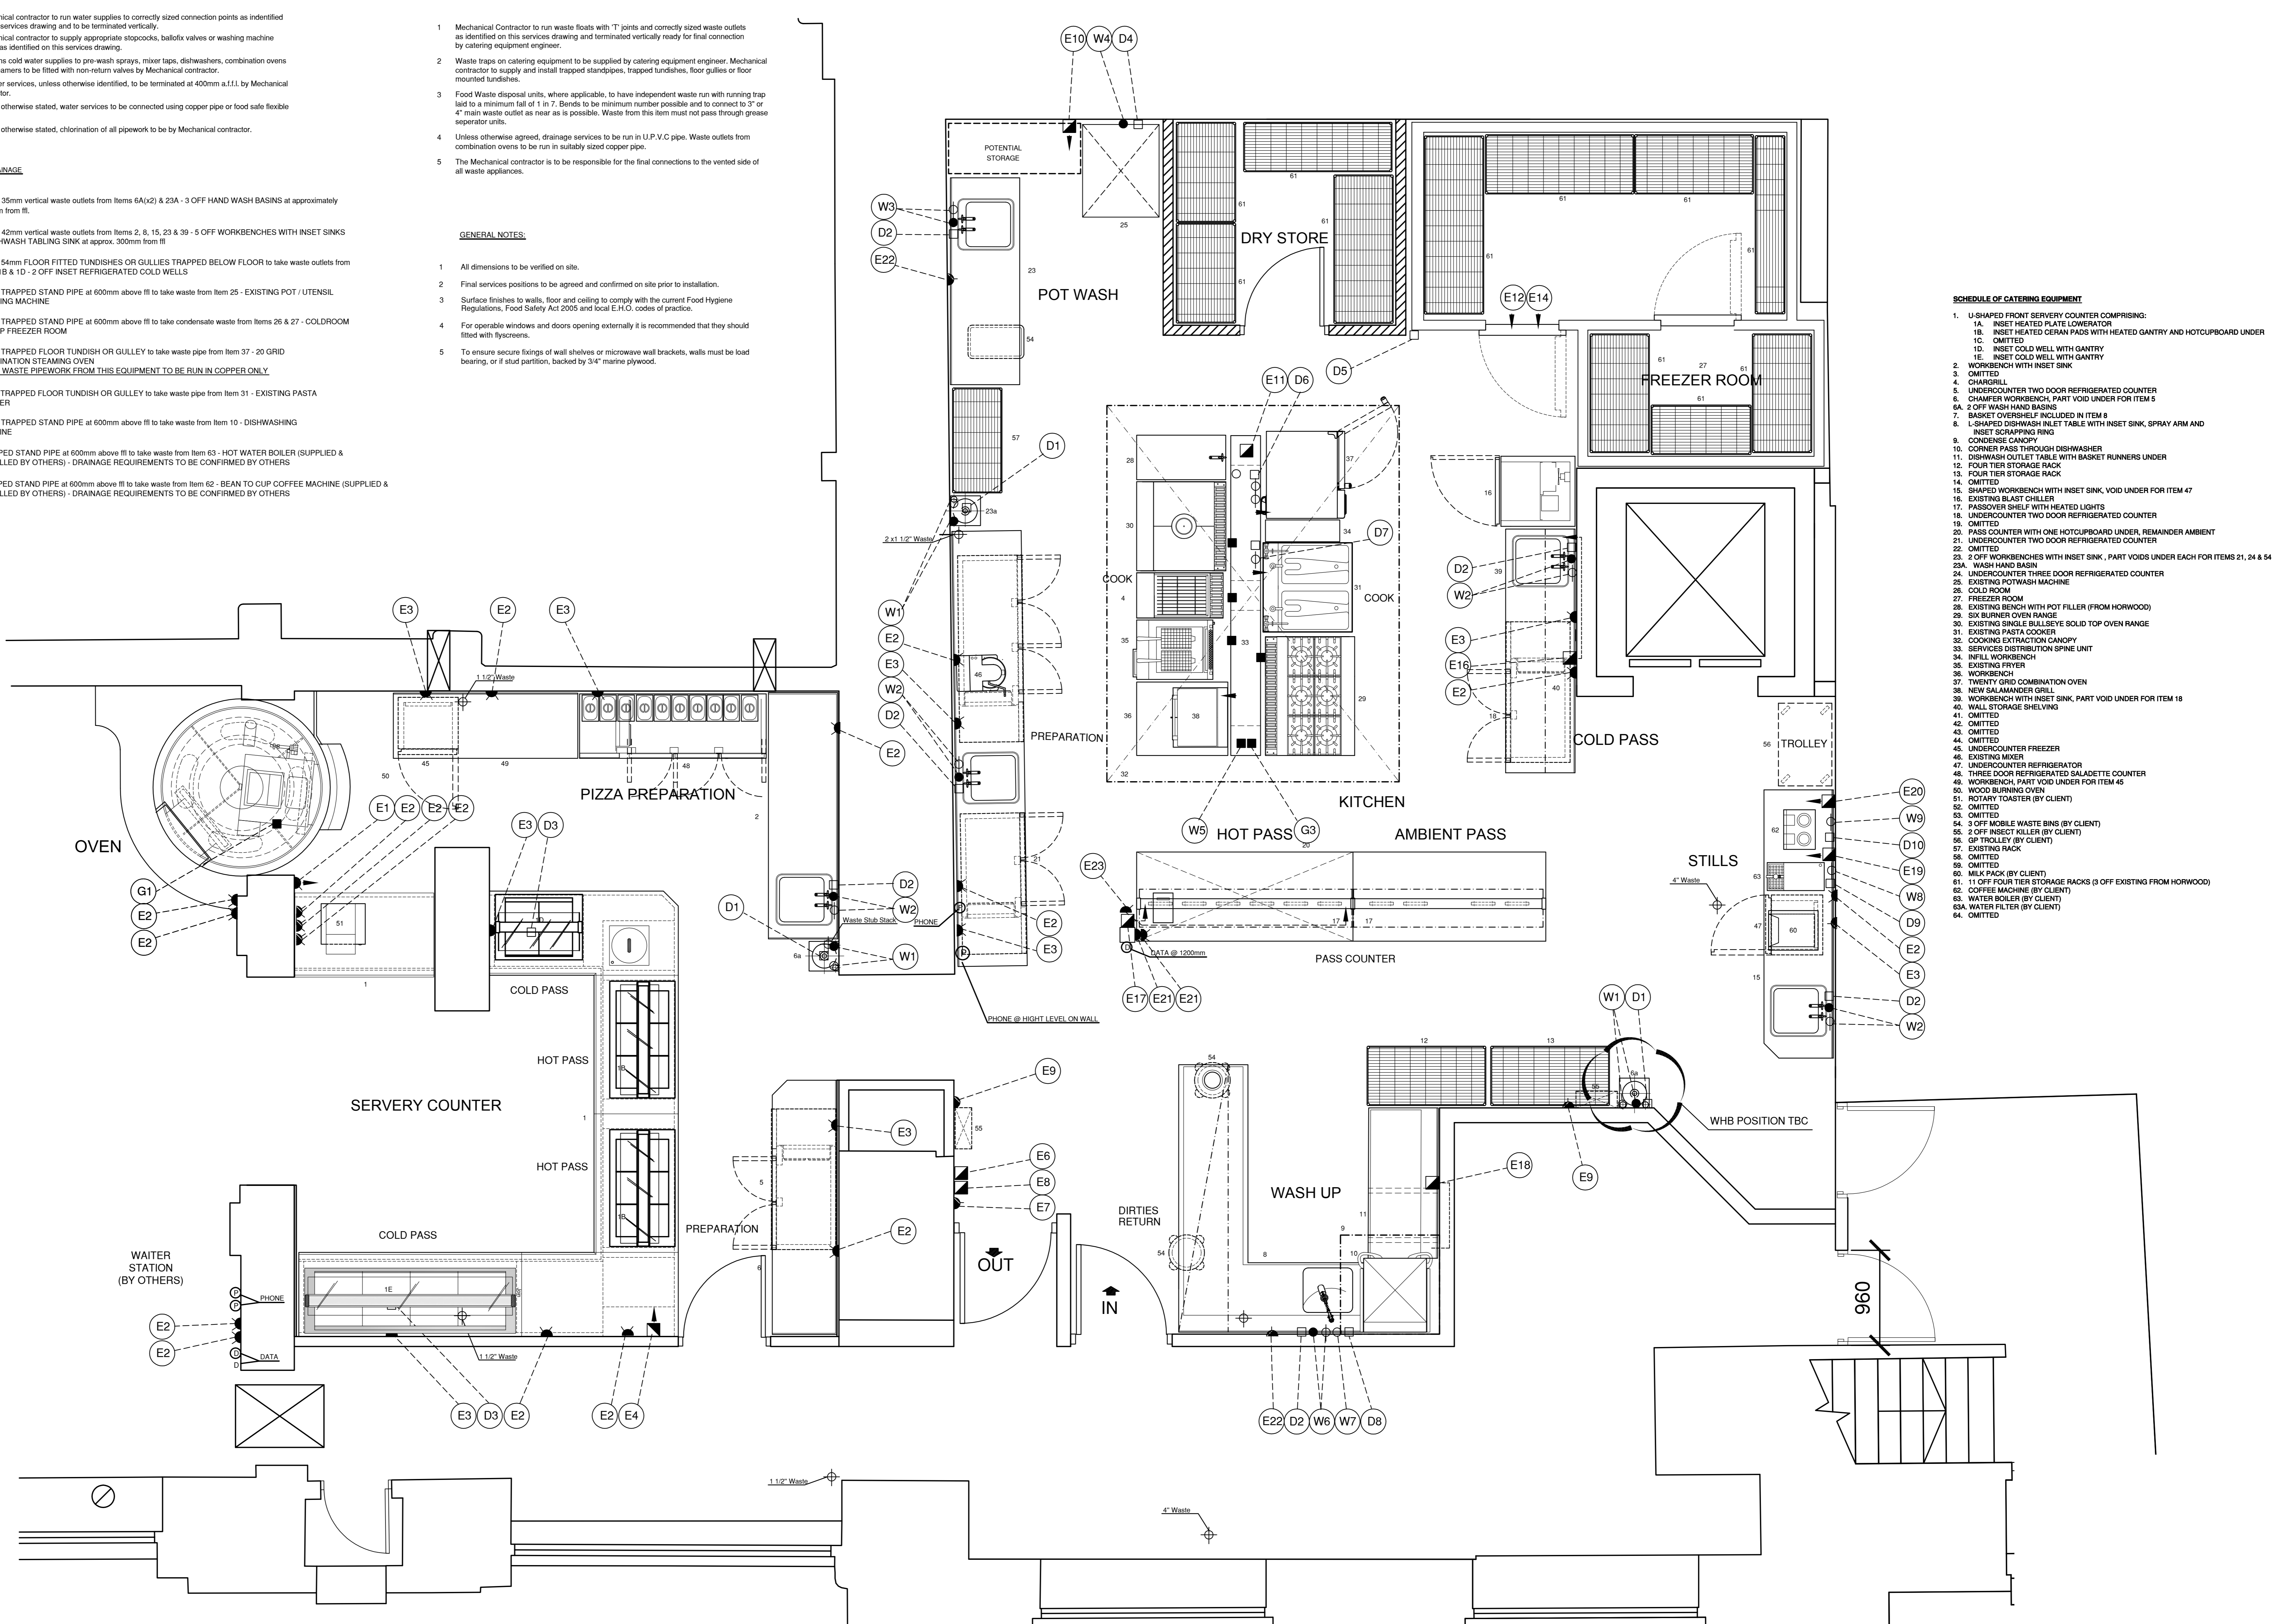

SERVICES SYMBOLS

- Single 13 Amp S.S.O. symbol, Twin 13 Amp S.S.O. symbol, 13 Amp Switched Spur symbol, Isolator and Connection Outlet symbol, Gas symbol, Tank Hot Water symbol, Mains Cold Water symbol, Tank Cold Water symbol, Waste symbol, Phone symbol, Data symbol.

SCHEDULE OF CATERING EQUIPMENT

- 1. U-SHAPED FRONT SERVERY COUNTER COMPRISING: 1A. INSET HEATED PLATE COWMATOR...

RECORD DRAWING



CLIENT: PRINCIPAL HAYLEY HOTELS
PROJECT: GLASGOW CENTRAL HOTEL - TEMPUS LEVEL KITCHEN CATERING EQUIPMENT SERVICES LAYOUT
SCALE: 1:25
DATE: 14.04.2011
PROJECT No: 21001019-7