

ELECTRIC

- E1 0.5 Amp (SpANAE) electrical supply to Switched Spur mounted on wall at 1200mm above...

- E16 16 Amp (SpANAE) electrical supply to Switched Spur mounted on wall at 1200mm above...

- E19 Electrical supply to isolator switch mounted on wall at 1200mm above...

ELECTRICAL NOTES

- 1 All equipment to be earth bonded by site electrical contractor.

GAS

- G1 22mm Bsp Natural Gas connection to Item 50 (WOOD BURNING OVEN) - 115,000 Btu/Hr...

WATER

- W1 3 OFF 15mm HOT & TANK COLD WATER supplies terminated vertically against wall with stopcocks...

WATER NOTES

- 1 Mechanical Contractor to run water supplies to correctly sized connection points as identified...

DRAINAGE


- D1 3 OFF 35mm vertical waste outlets from Items 6A(2) & 23A - 3 OFF HAND WASH BASINS...

DRAINAGE NOTES

- 1 Mechanical Contractor to run waste floats with 'T' joints and correctly sized waste outlets...

GENERAL NOTES

- 1 All dimensions to be verified on site.

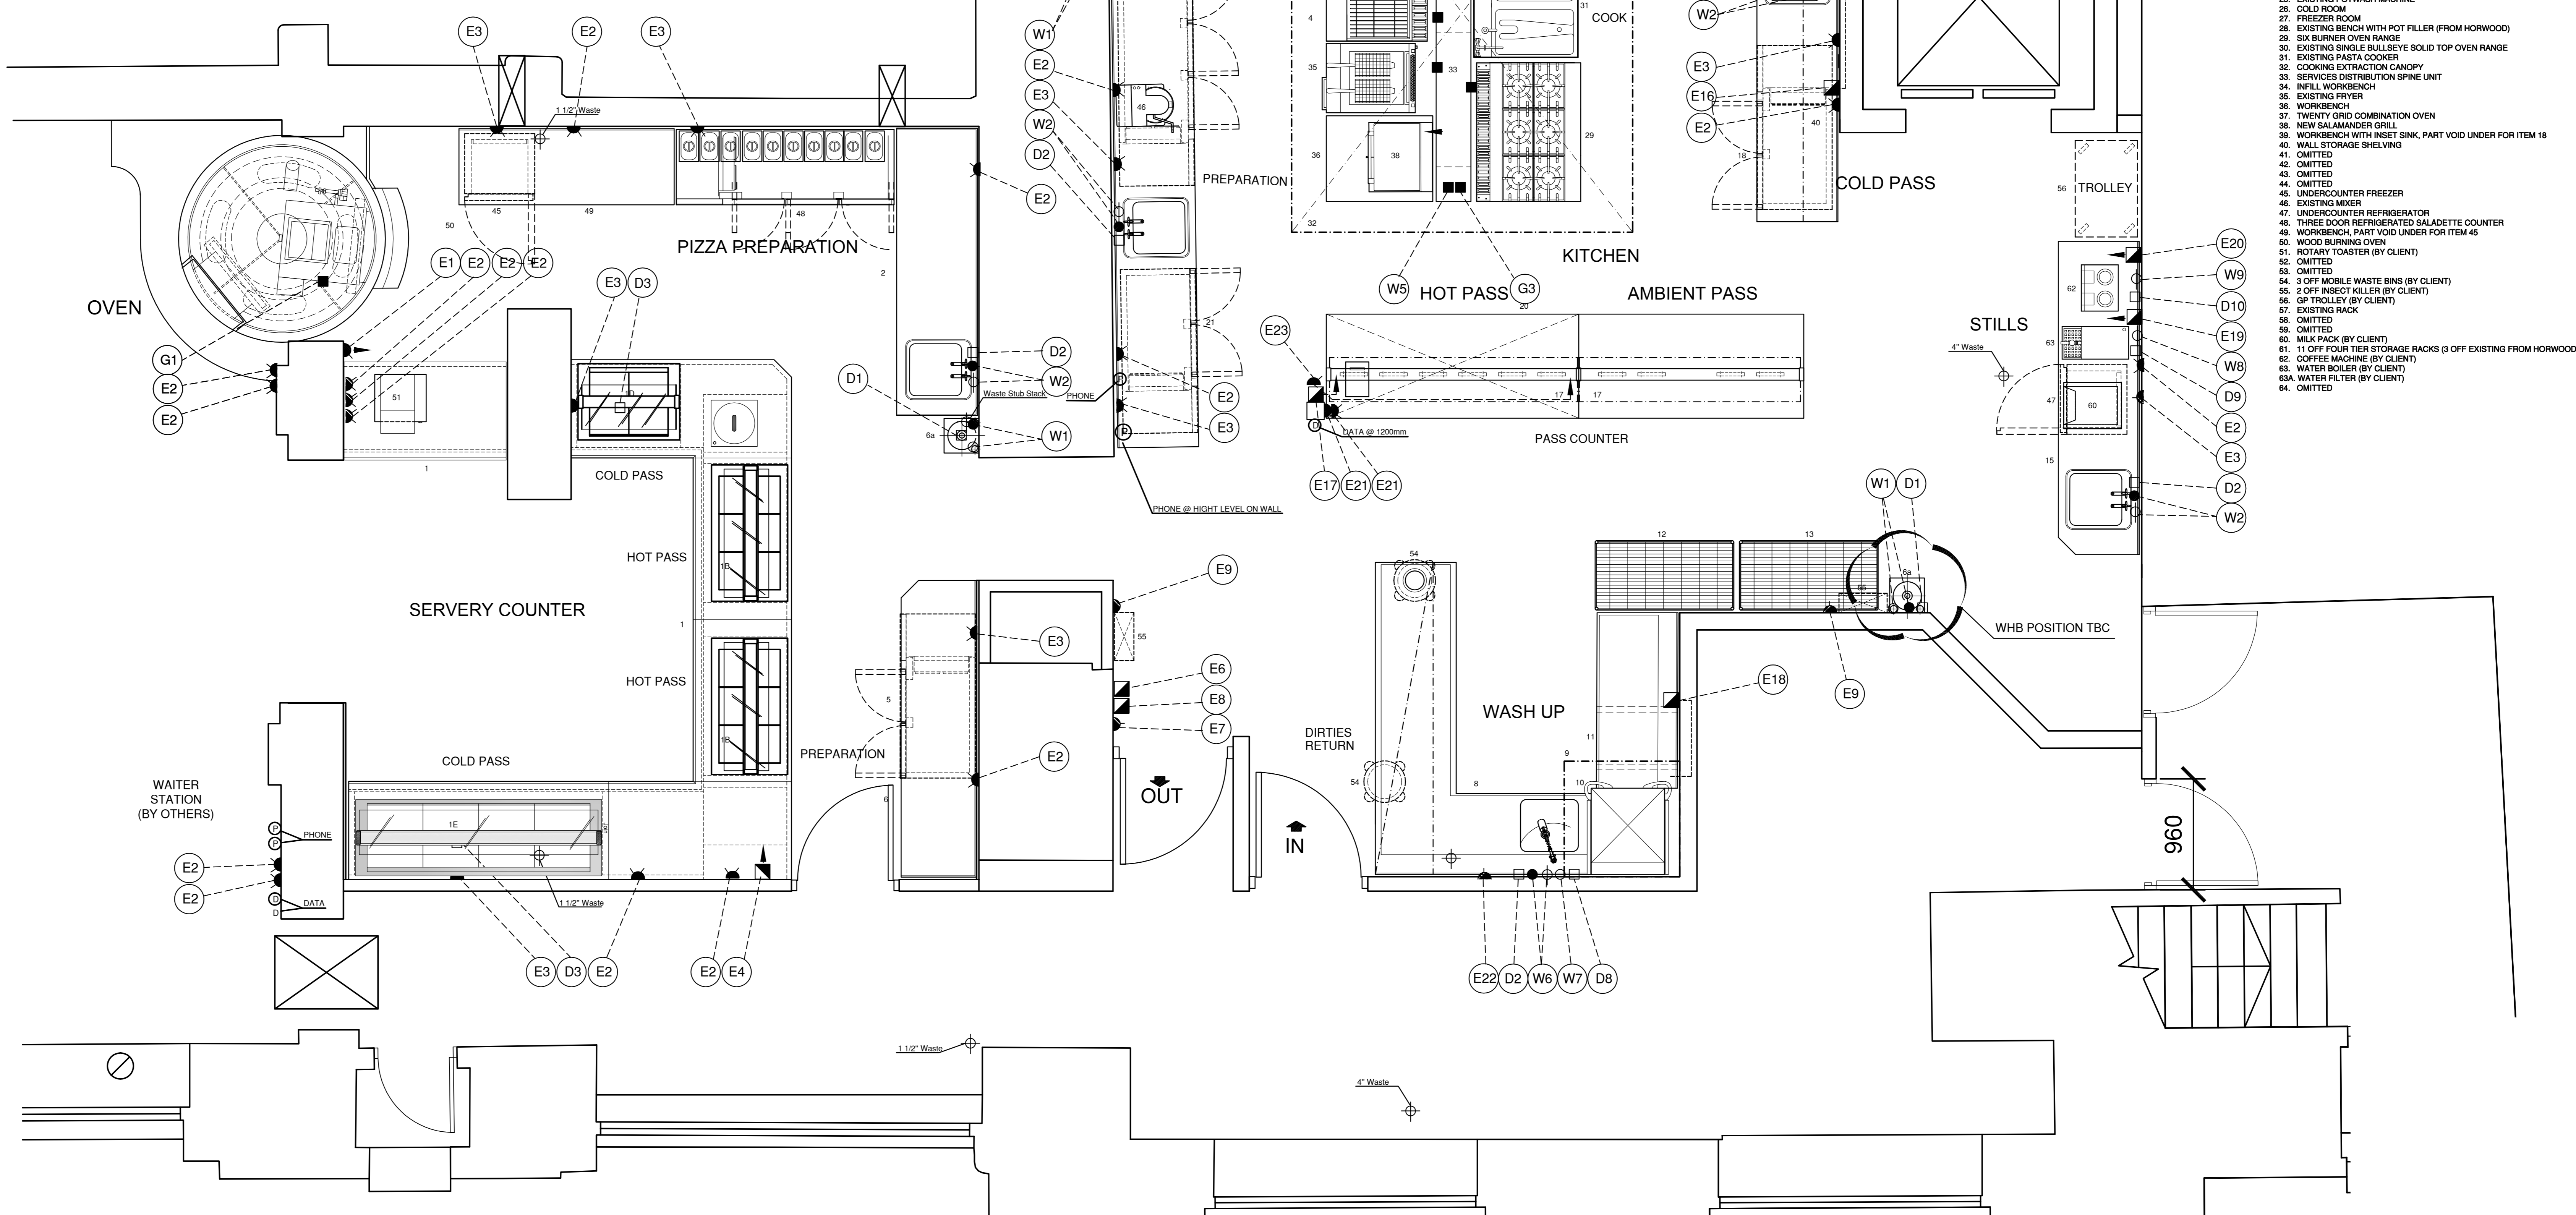

SERVICES SYMBOLS



SCHEDULE OF CATERING EQUIPMENT

- 1. U-SHAPED FRONT SERVERY COUNTER COMPRISING: 1A. INSET HEATED PLATE COWMATOR...

RECORD DRAWING

Project information including Client (Principal Hayley Hotels), Project (Glasgow Central Hotel - Tempus Level Kitchen Catering Equipment Services Layout), Scale (1:25), Date (14/04/2010), and Project No. (21001019-7).