




View From Arrow A

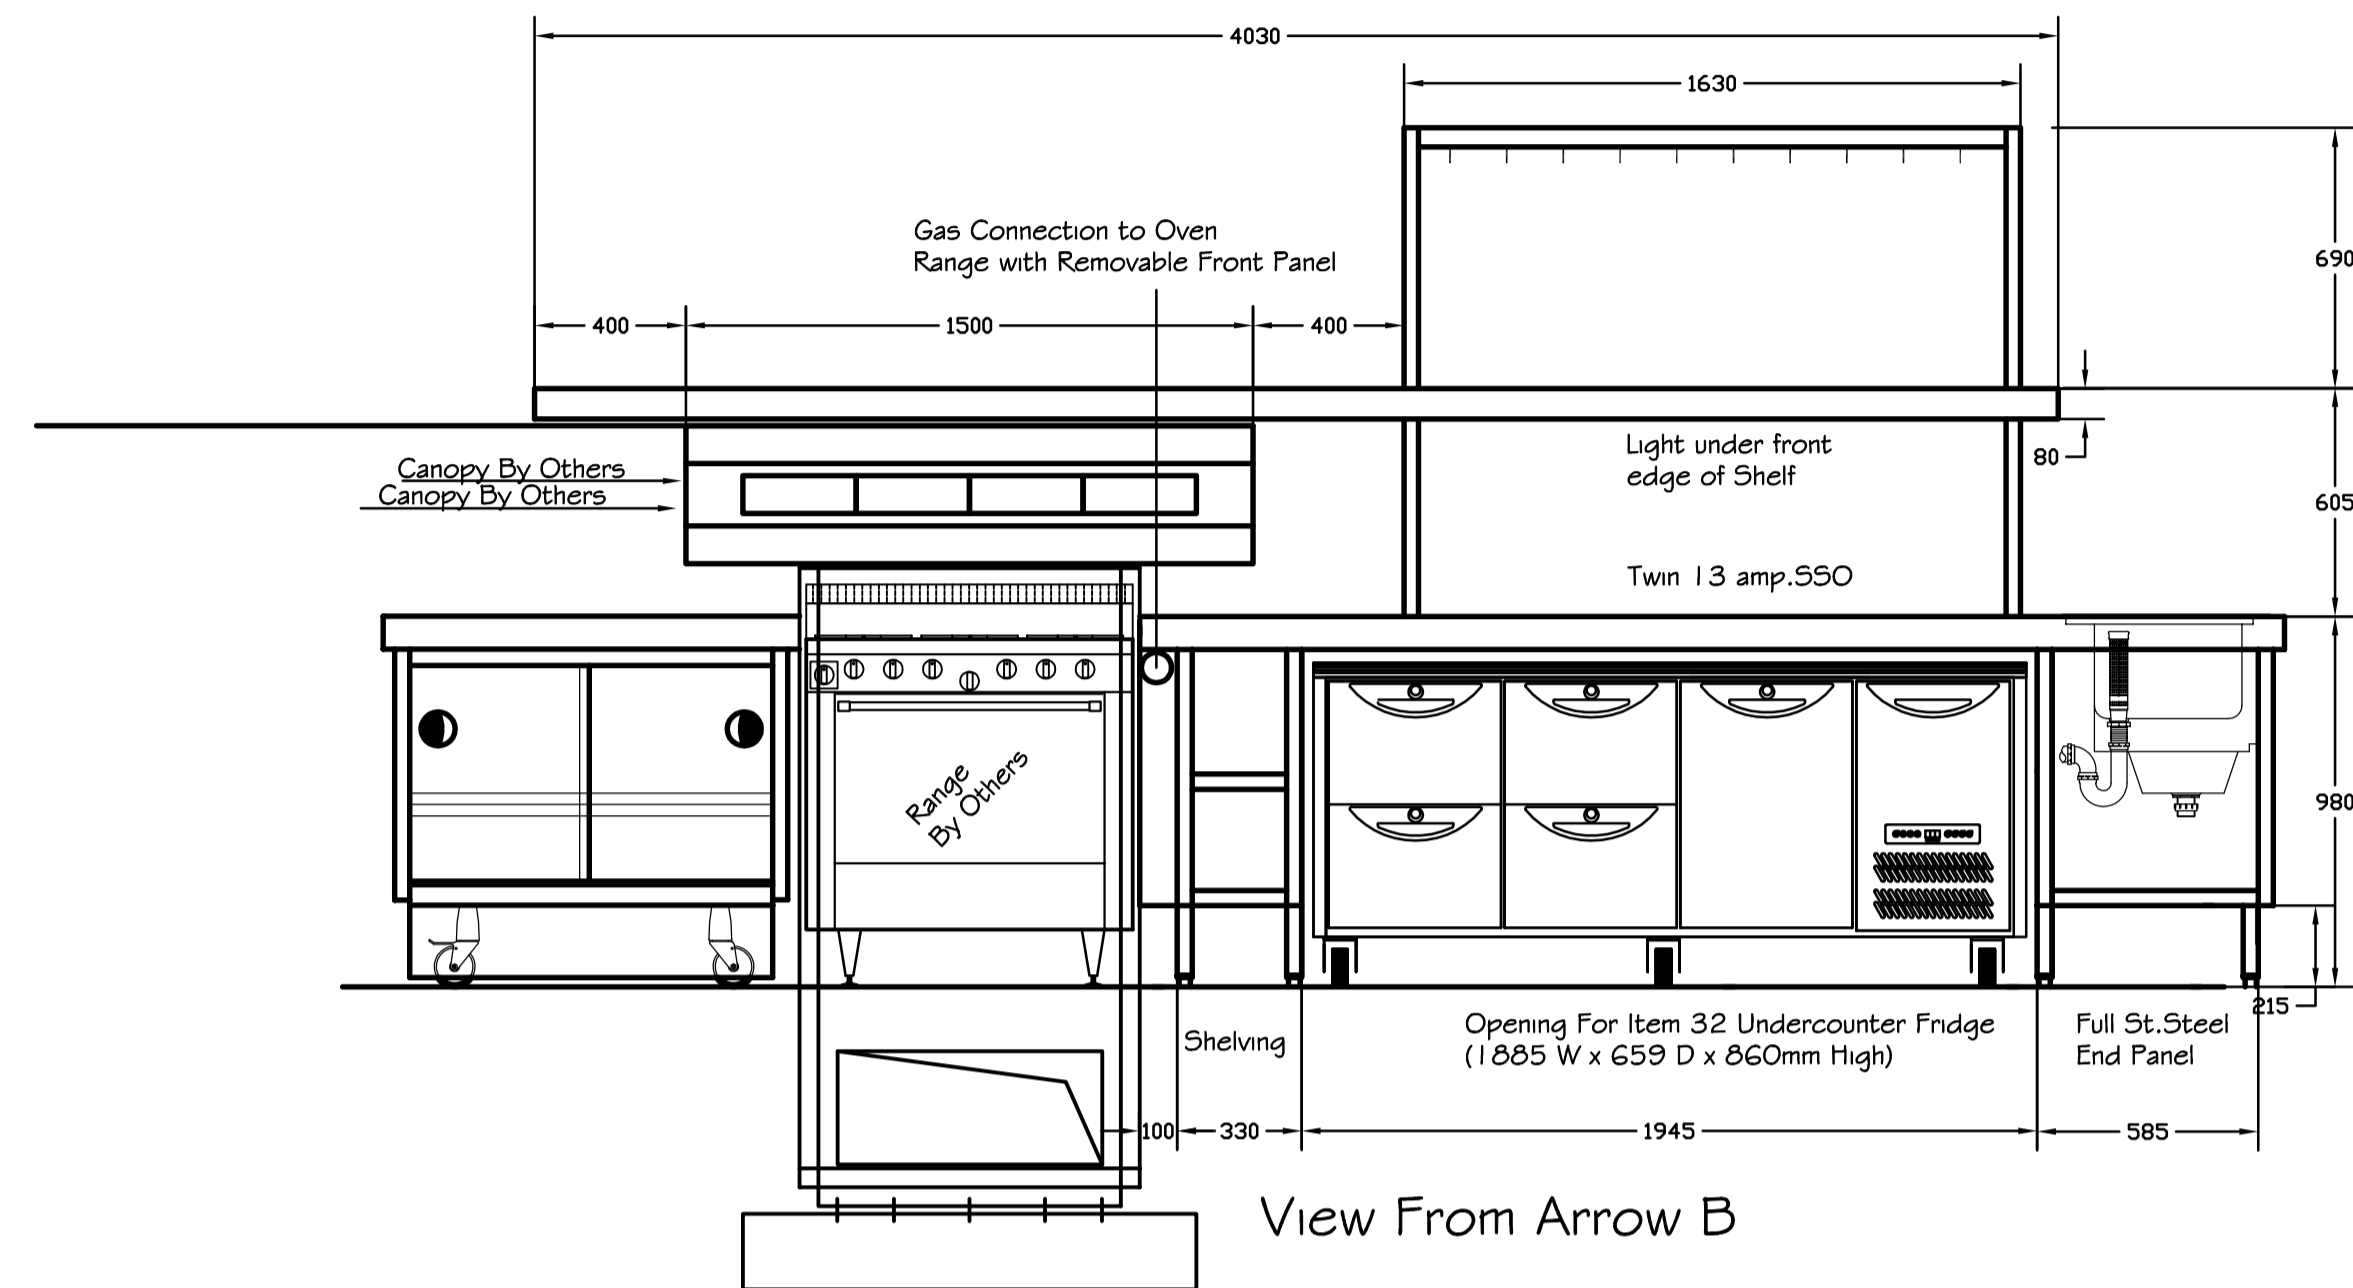


View From Arrow B

NOTE

See Drawing 3679-03
For Details Of This Unit

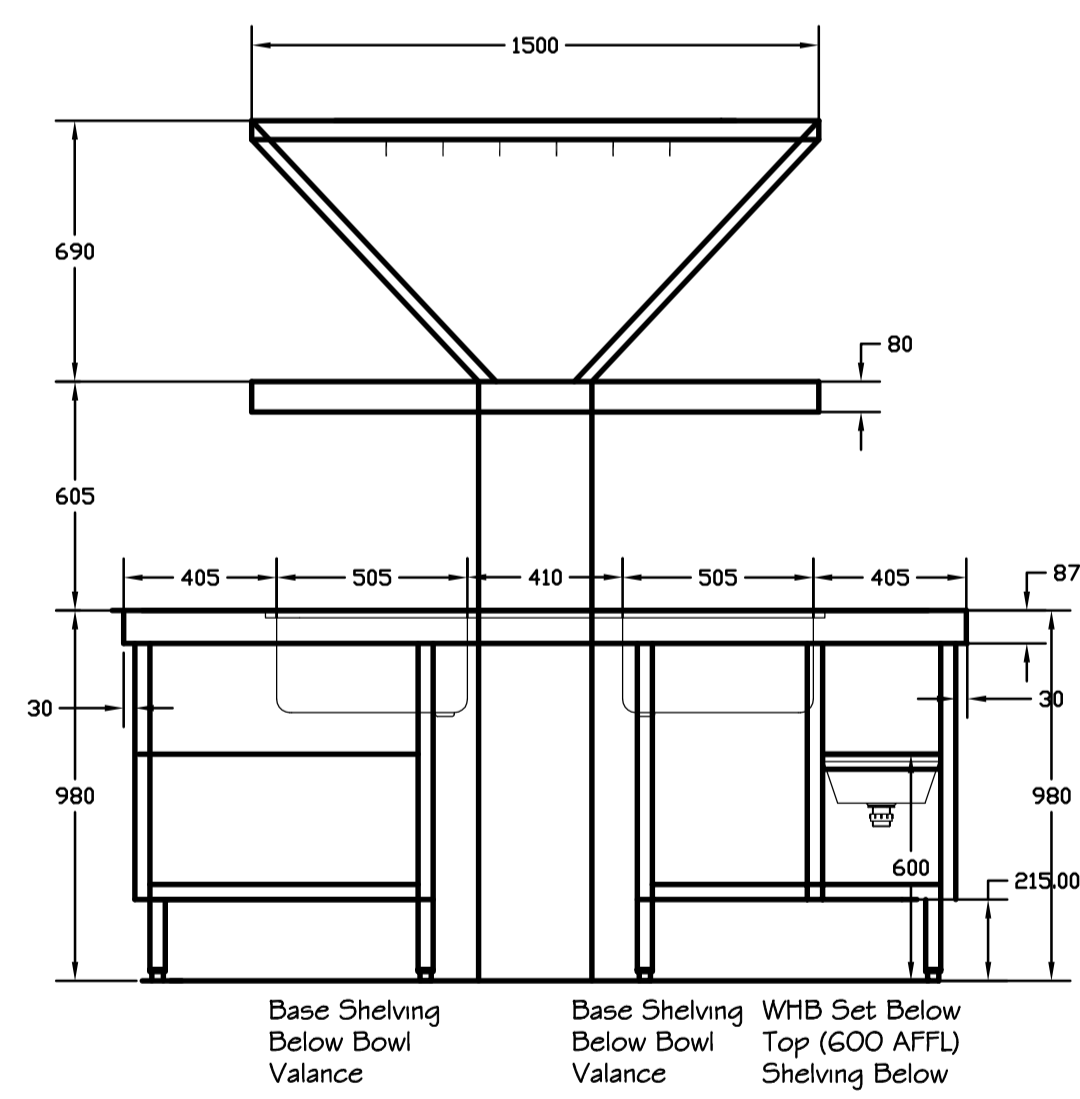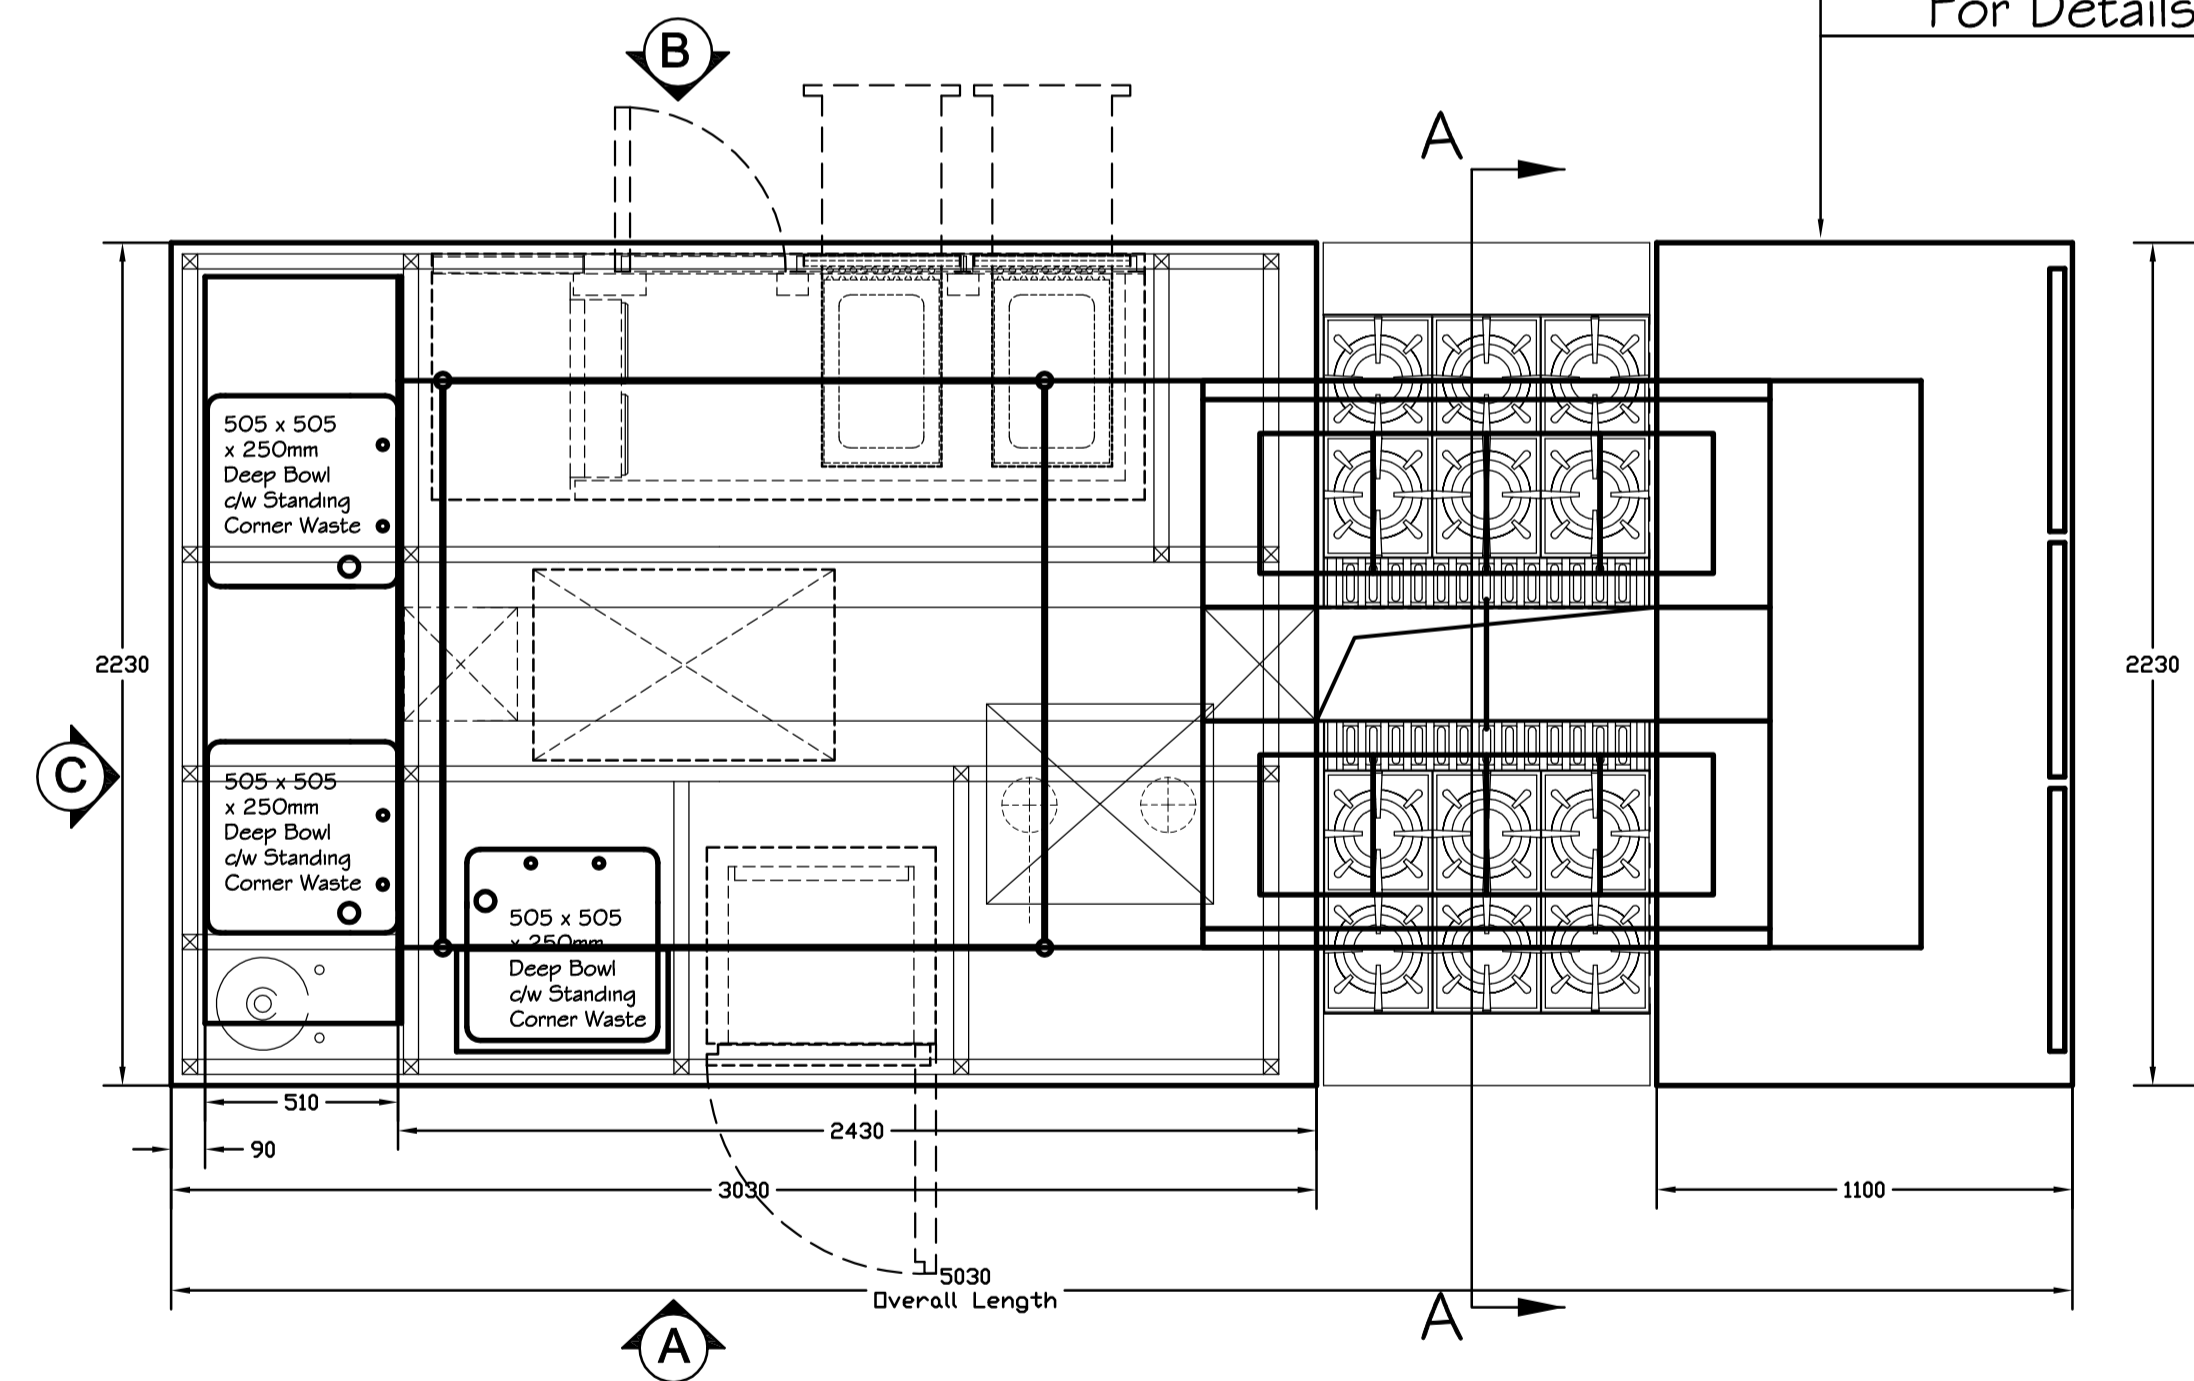

View From Arrow C

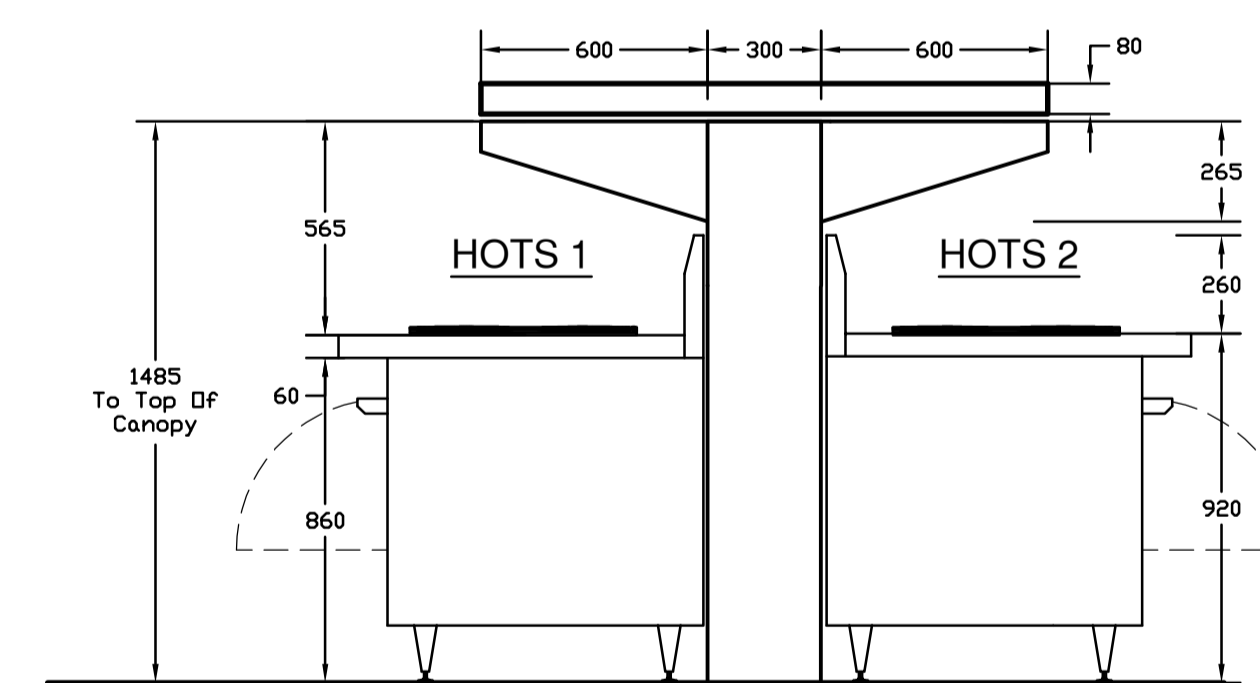

Section A-A

RECORD DRAWING



COURT CATERING
EQUIPMENT LTD
UNIT 1, ACTON VALE INDUSTRIAL PARK,
COWLEY ROAD, LONDON W3 7QE
TEL: 020 8746 0808
FAX: 020 8746 1116
E-mail: projects@courtcatering.co.uk

CLIENT:
RIVER CAFE
PROJECT:
RIVER CAFE
THAMES WHARF
ITEM 35 S/S ISLAND WORKTOP UNIT ELEVATIONS
AND SECTION LAYOUT

SCALE: 1:20
DATE: -
DRAWN: B.M. (CAD)
PM: A.A.F.

PROJECT No: 2710429-4

© COPYRIGHT COURT CATERING EQUIPMENT LTD
THIS DRAWING MUST NOT BE REPRODUCED, MULTIPLIED
OR SUBMITTED TO THE INSPECTION OF THIRD PARTIES
WITHOUT OUR PRIOR PERMISSION.
WRITTEN DIMENSIONS TO BE PREFERRED.
ALL DIMENSIONS TO BE CHECKED AND VERIFIED ON
SITE.
ALL RIGHTS RESERVED.

